


01. Long section A-B

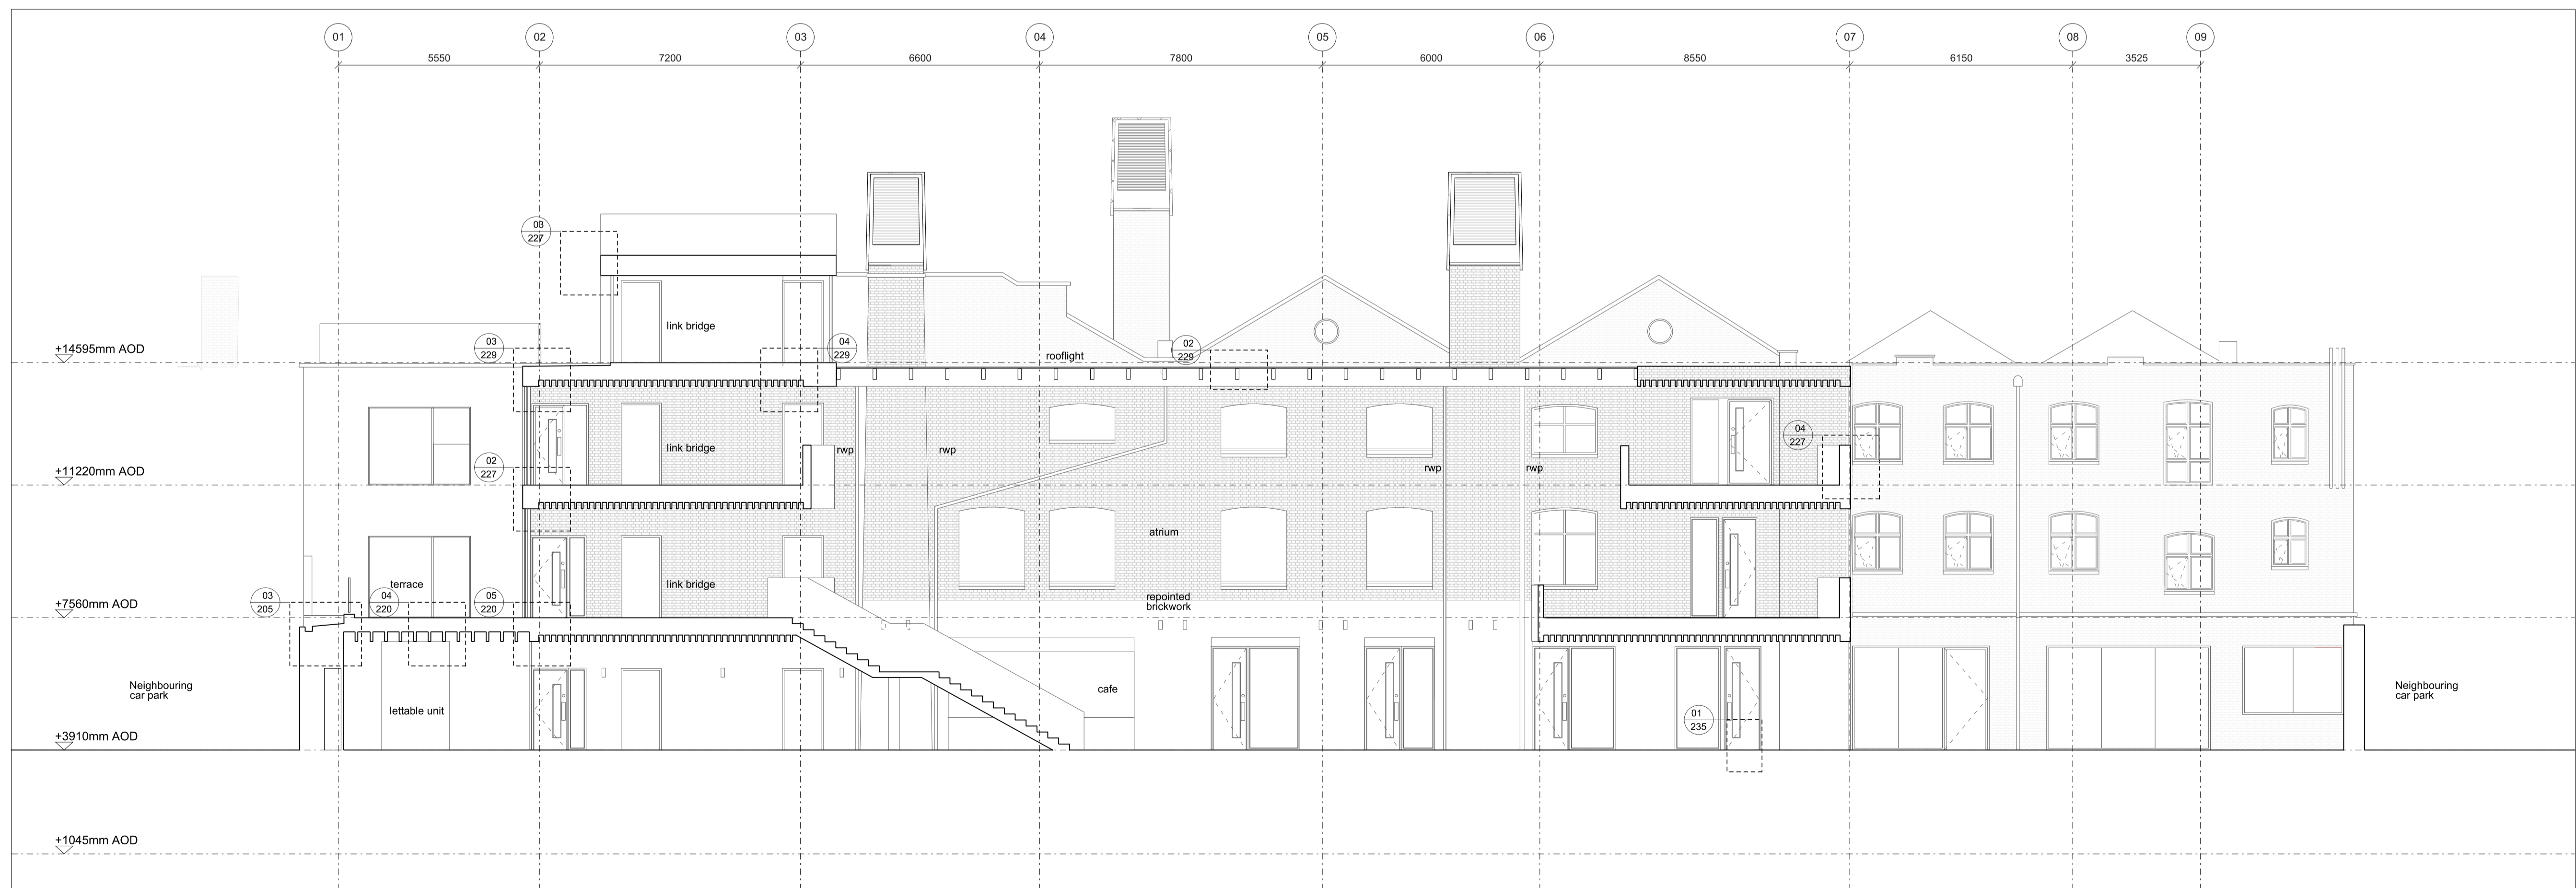

02. Long Section C-E

00 01 05 10m

F AS BUILT 16/08/2014  
 E Details added 06/11/2013  
 D CONSTRUCTION ISSUE 06/08/2013  
 C Changes from tender set included inc: Always glazing structural spacing amended; Window opening lights reduced; Spacelock changed; Dimensional spacing changed to match component drawings  
 B Minor amendments 18/02/2013  
 A Minor amendments 29/11/2012  
 Rev Notes Date

Do not scale from this drawing. Check all dimensions on site.  
 Sheela Cooper-Plan

Graphic Scale:

0	1	2	3	4	5	6	7	8	9	10
---	---	---	---	---	---	---	---	---	---	----

Project:  
**Social Justice Centre**  
 17-19 Oval Way  
 SE11 5RN  
 Proposed Long Sections  
 A-B, C-E

**00:01** Architecture 00 Ltd.  
 The Hub, 1st Floor N24  
 85 Hopton Street  
 London SW1Y 4TE  
 www.architecture00.net E: info@architecture00.net

Scale: 1:100 @ A1	Drawn: LP	Issued: LP	Date: 17/07/12
Project No: 0144	Drawing No: D144 (L)020	Revision: F	