


LONDON + GUERNSEY

198 Blackstock Road, London N5 1EN
T 020 7354 1729
E studio@souparchitects.com

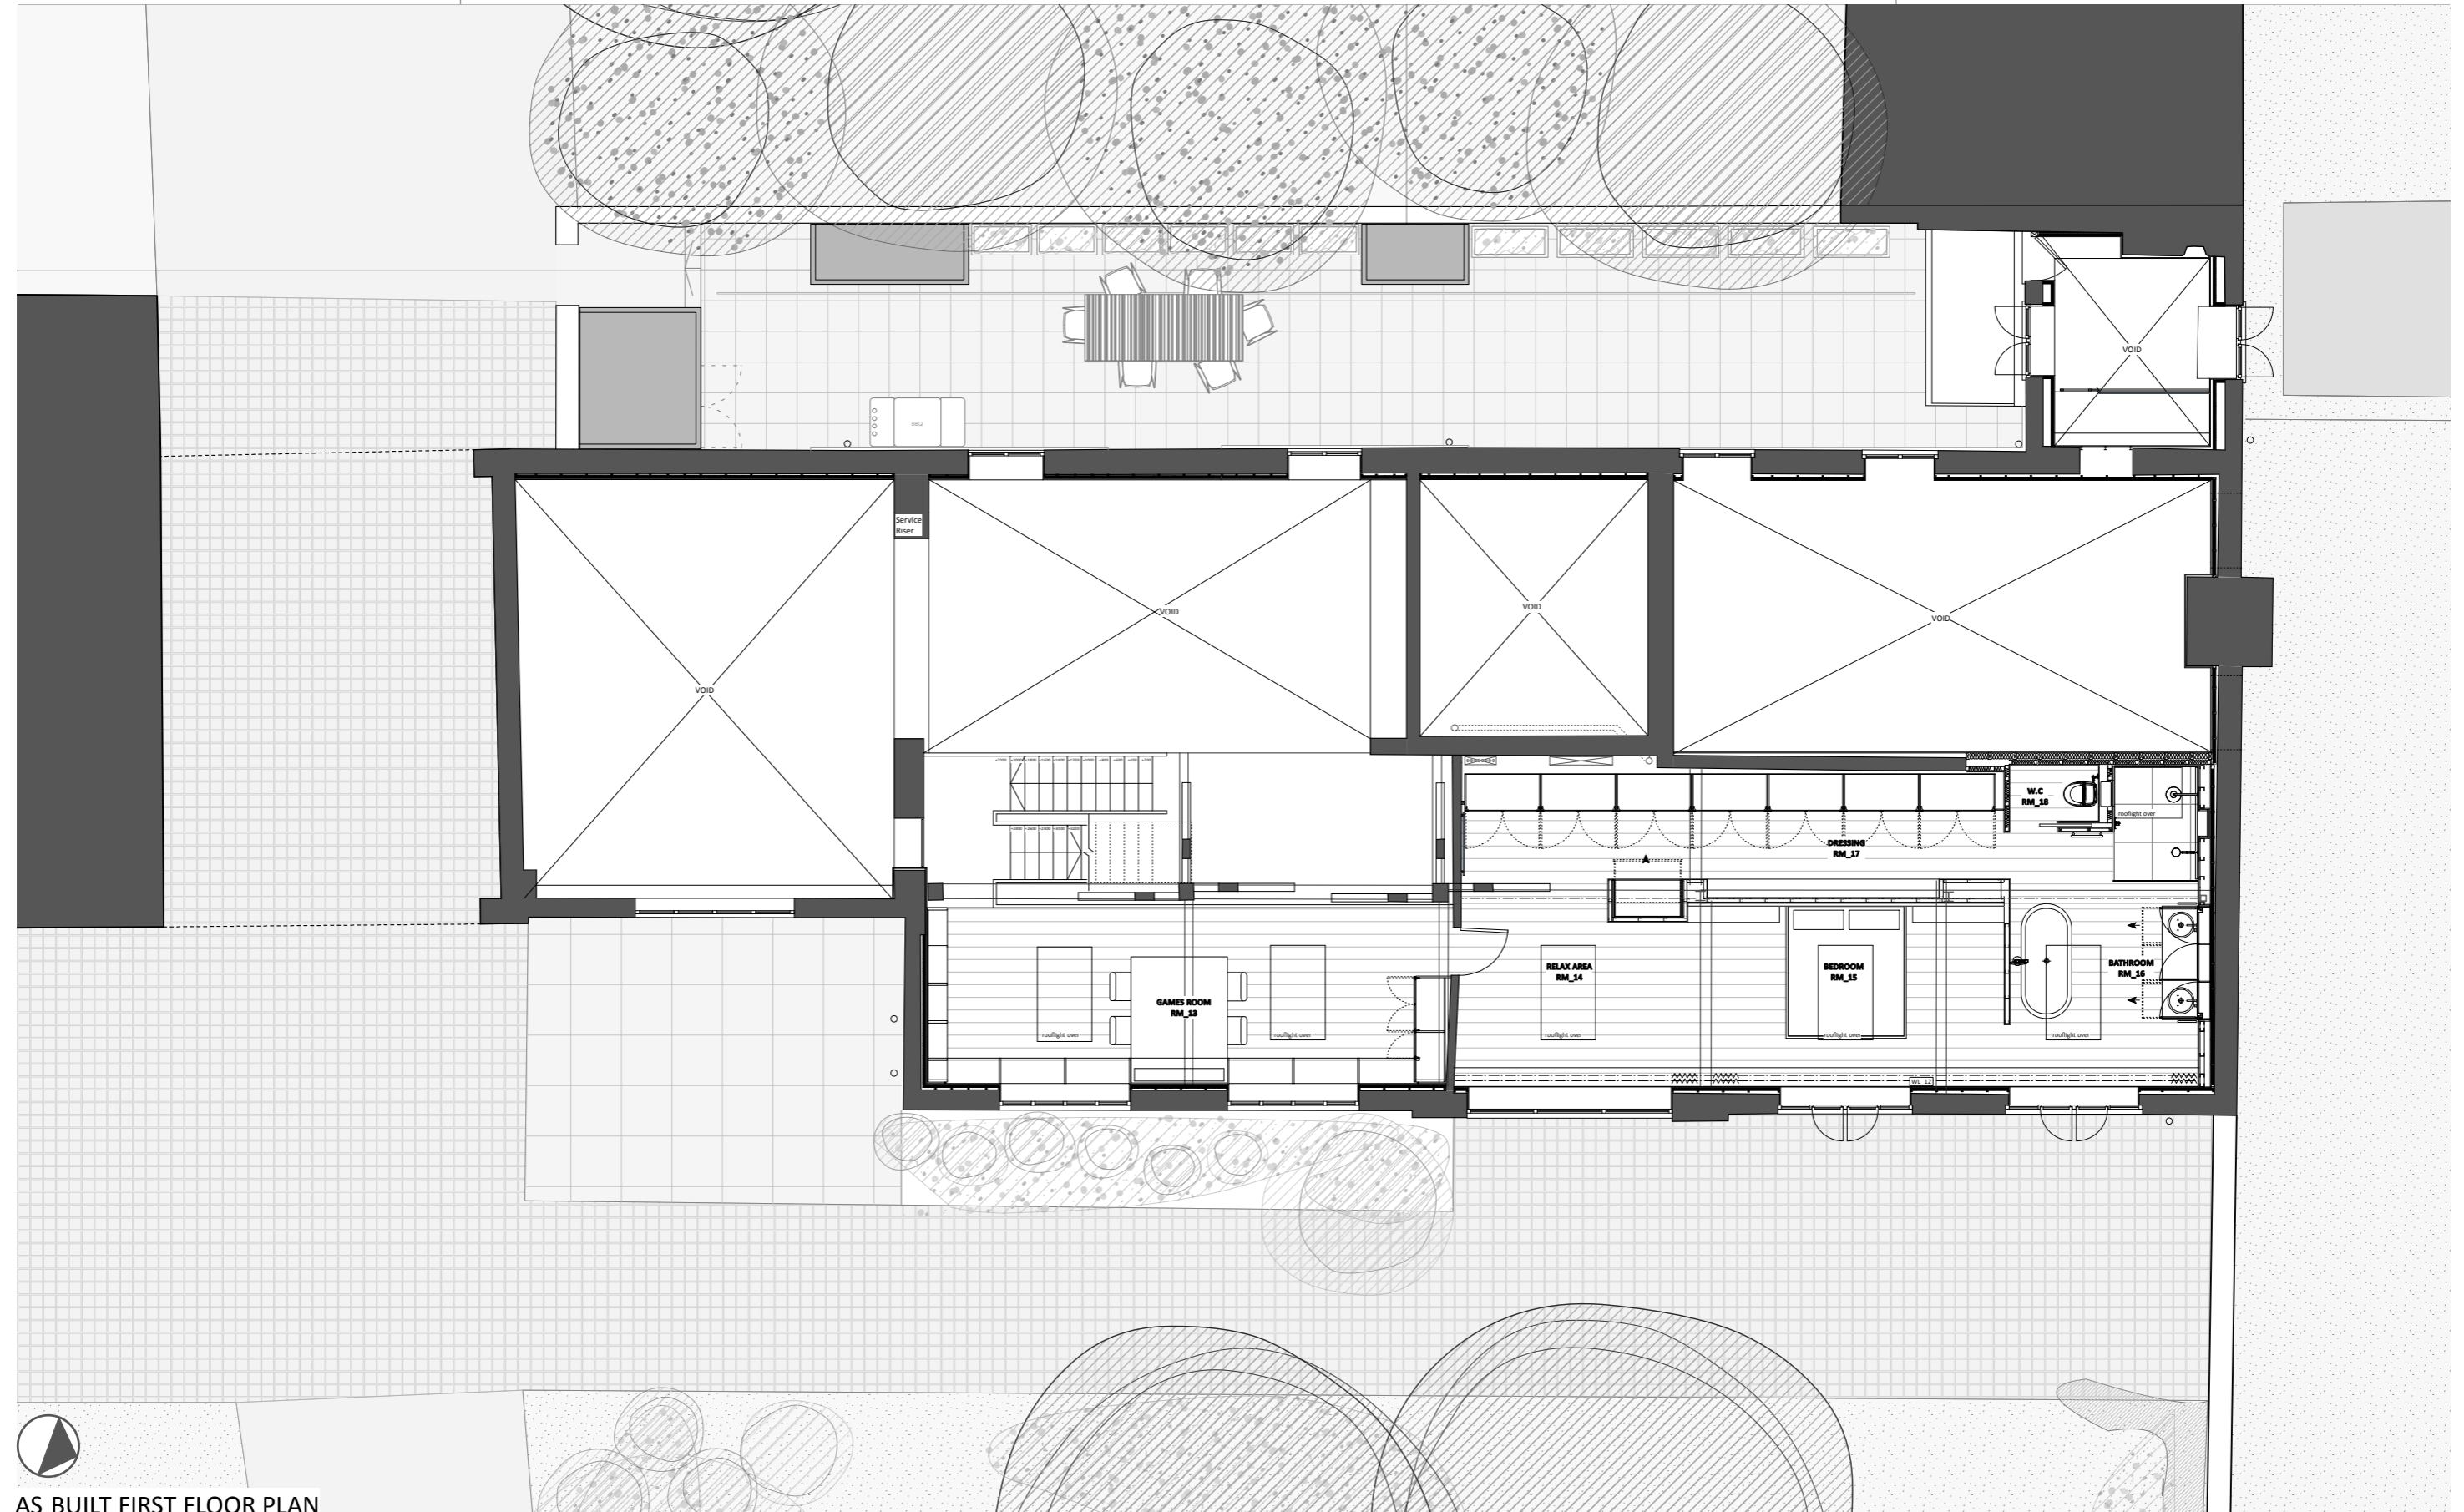

AS BUILT FIRST FLOOR PLAN