


LONDON + GUERNSEY

198 Blackstock Road, London N5 1EN
 T 020 7354 1729
 E studio@souparchitects.com

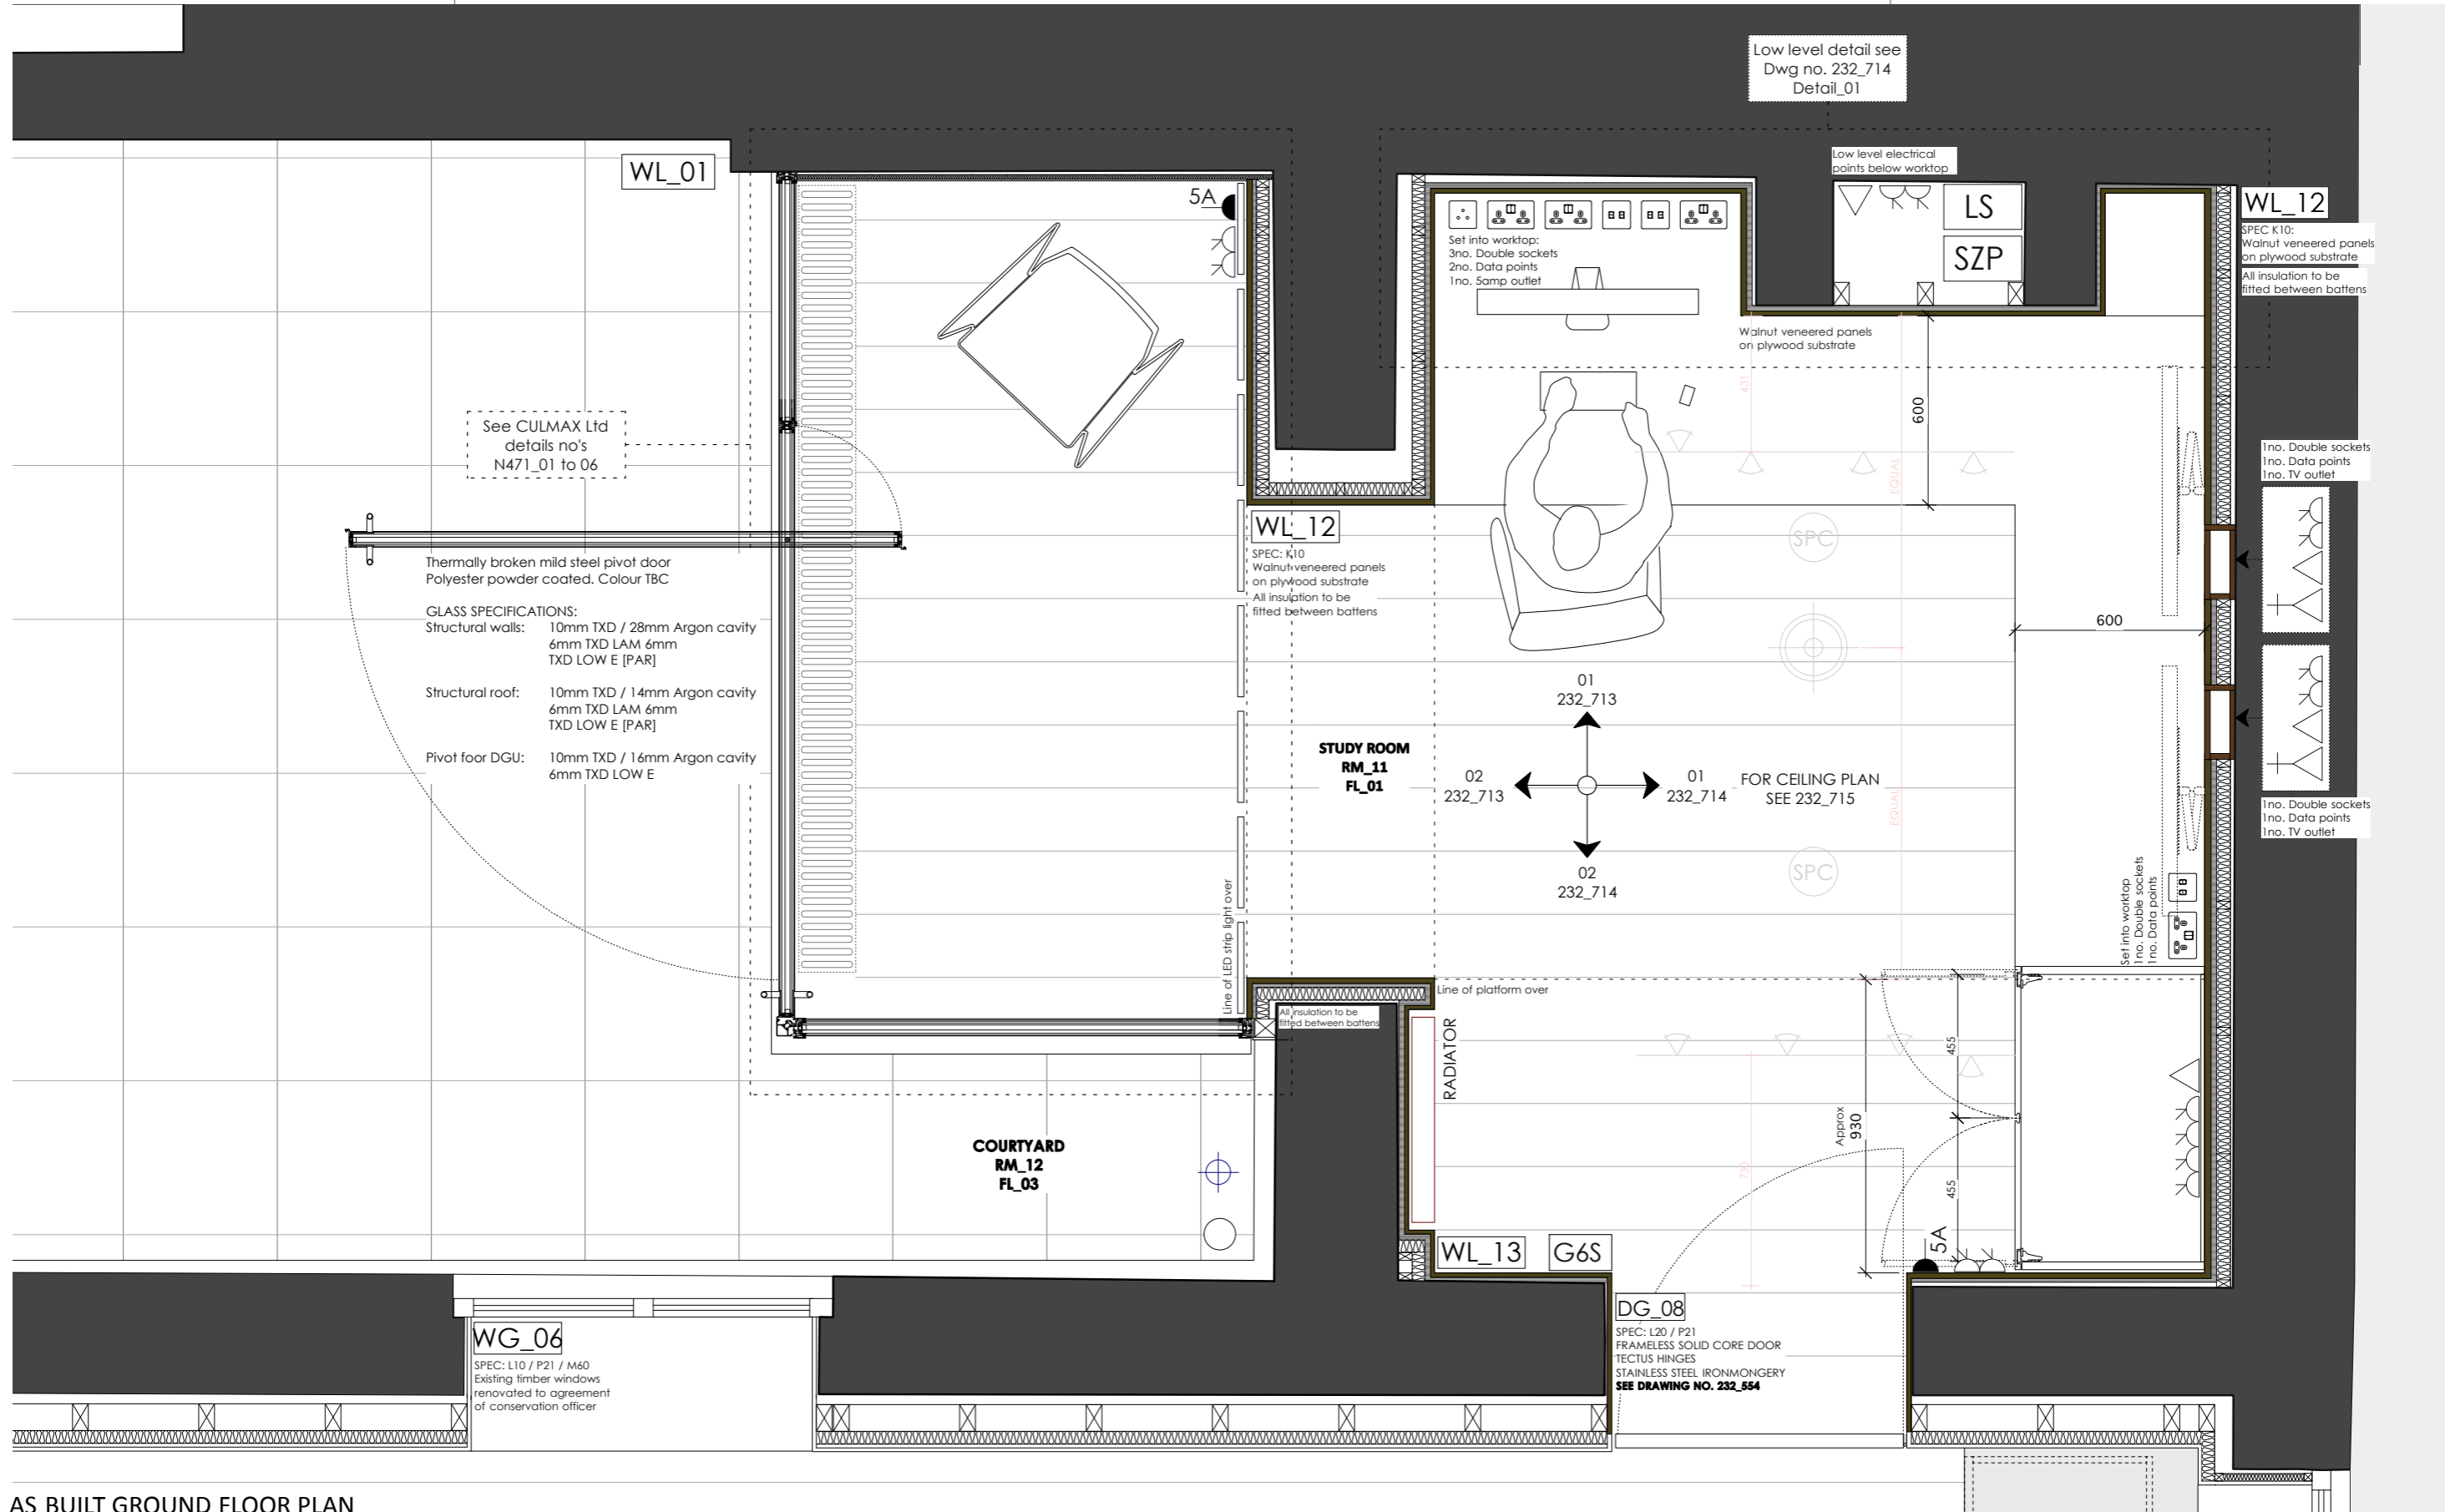

AS BUILT GROUND FLOOR PLAN