SOUP

LONDON + GUERNSEY

198 Blackstock Road, London N5 1EN
T 020 7354 1729
E studio@souparchitects.com

THE OAKS, RICHMOND UPON THAMES, LONDON

AJ BUILDINGS LIBRARY

SEPTEMBER 2012

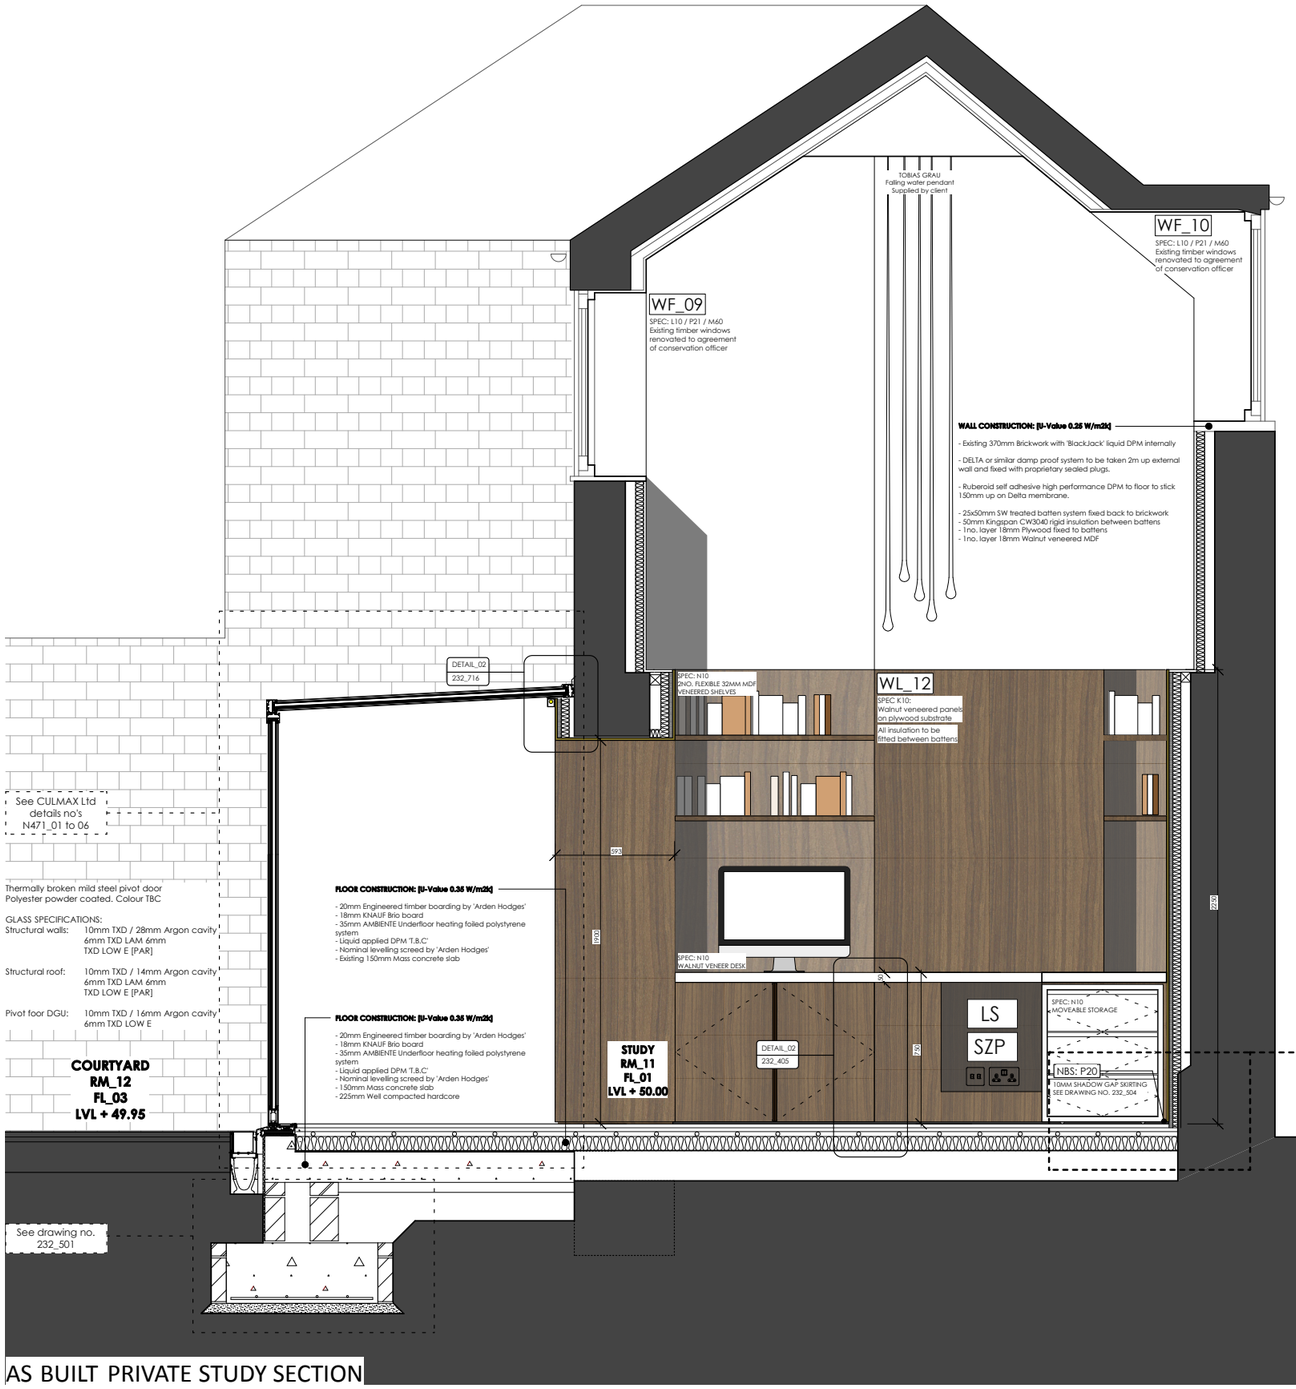

AS BUILT PRIVATE STUDY SECTION

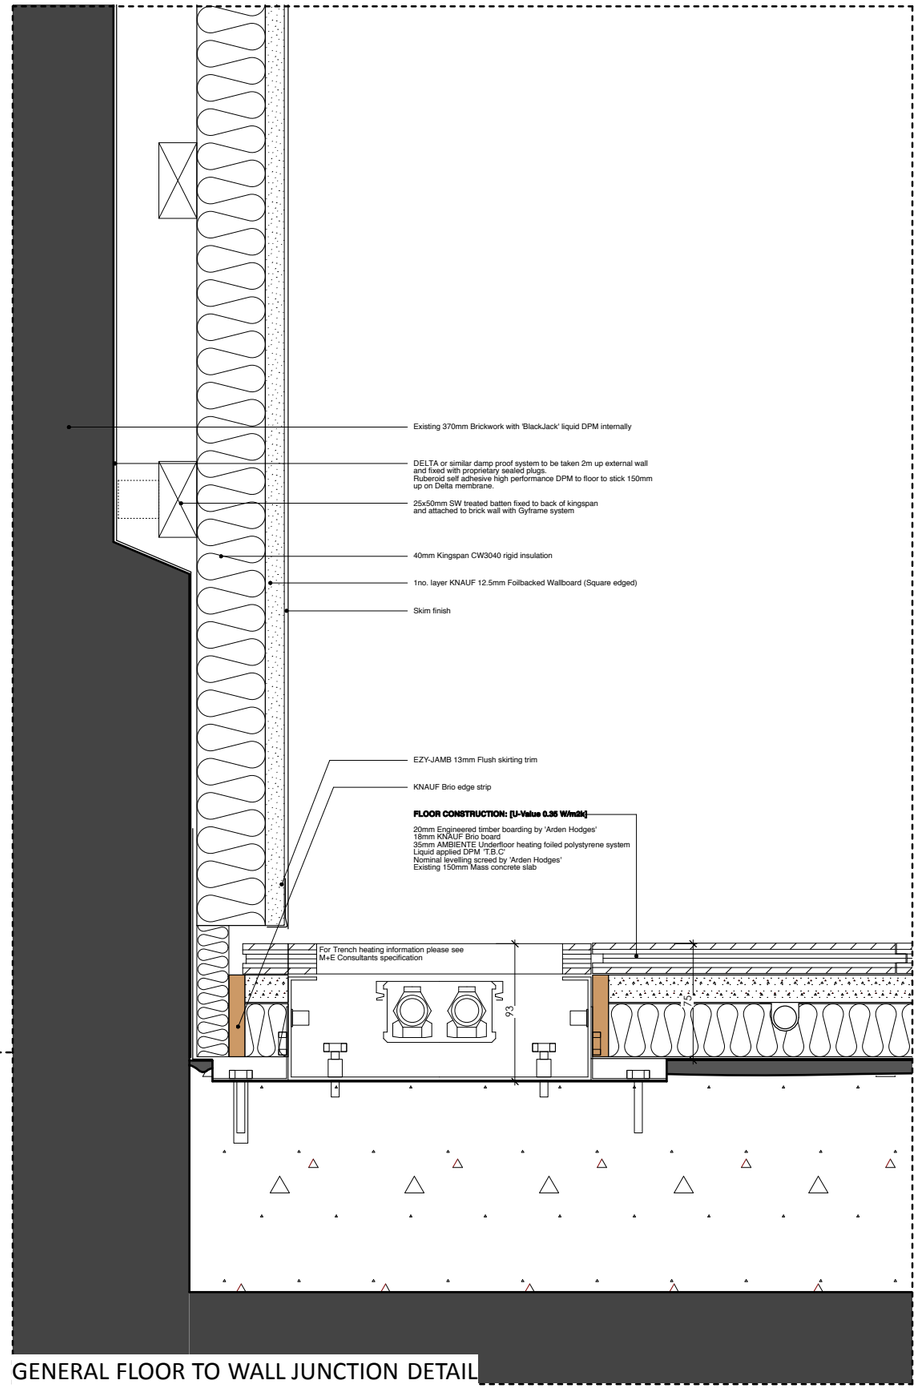

GENERAL FLOOR TO WALL JUNCTION DETAIL

COPYRIGHT OF SOUP ARCHITECTS Ltd