CHAIRS / SEATING

A	-	17NO.	DINING SIDE CHAIR (TORUS BY SATELLIET)
B	-	16NO.	DINING ARMCHAIR
C	-	6NO.	CROISSANT LOUNGE CHAIR (BY SATELLIET) (SUITABLE FOR DINING)
D	-	2NO.	LOW COMFY LOUNGE CHAIR (FIRE PLACE)
E	-	2NO.	2 SEATER SOFA
F	-	2NO.	LOW STOOL (METAL FRAME BY COX & COX)
G	-	8NO.	HIGH BAR CHAIR
K	-	4NO.	CAFE SIDE CHAIR
H	-	14NO.	TOLIX STYLE ARMCHAIR (EXTERNAL)
J	-	36NO.	PLASTIC COLOURED SIDECHAIR (EXTERNAL)
BENCH1	-	2 NO.	TIMBER BENCH - 1800X650

FIXED SEATING

FS1	-	1NO.	DINING HEIGHT F/SEAT - 6540x560
FS2	-	2NO.	DINING HEIGHT F/SEAT (FIREPLACE) - 800x560
FS3	-	2NO.	DINING HEIGHT F/SEAT (BOOTH STYLE) - 1500x560

TABLES

T1	-	4NO.	PEDSTAL BASE - DINING HEIGHT - 700x700
T2	-	5NO.	PEDSTAL BASE - DINING HEIGHT - 750x1200
T3	-	3NO.	DINING TABLE - 900x900
T4	-	1NO.	DINING TABLE - 800x800
T5	-	2NO.	DINING TABLE (SMALL) - 700Ø
T6	-	2NO.	PEDSTAL BASE - DINING HEIGHT - 800Ø
T7	-	1NO.	PEDSTAL BASE - DINING HEIGHT - 1000Ø
T8	-	1NO.	HIGH POSER RECLAIMED TABLE - 1800x700
T9	-	2NO.	LOW LAMP TABLE - 500x500
T10A	-	1NO.	TIMBER DINING TABLE - 900x900
T10B	-	2NO.	TIMBER DINING TABLE - 1500X800
T11	-	5NO.	RATTAN / TIMBER INSERT TABLES - 800x800
T12	-	6NO.	RATTAN / TIMBER INSERT TABLE - 1500x800
T13	-	1NO.	TIMBER DINING TABLE (BESPOKE) - 1800x900

OTHER

W/S 1-	1NO.	RECLAIMED BUTCHERS BLOCK UNIT 1730L X 650D

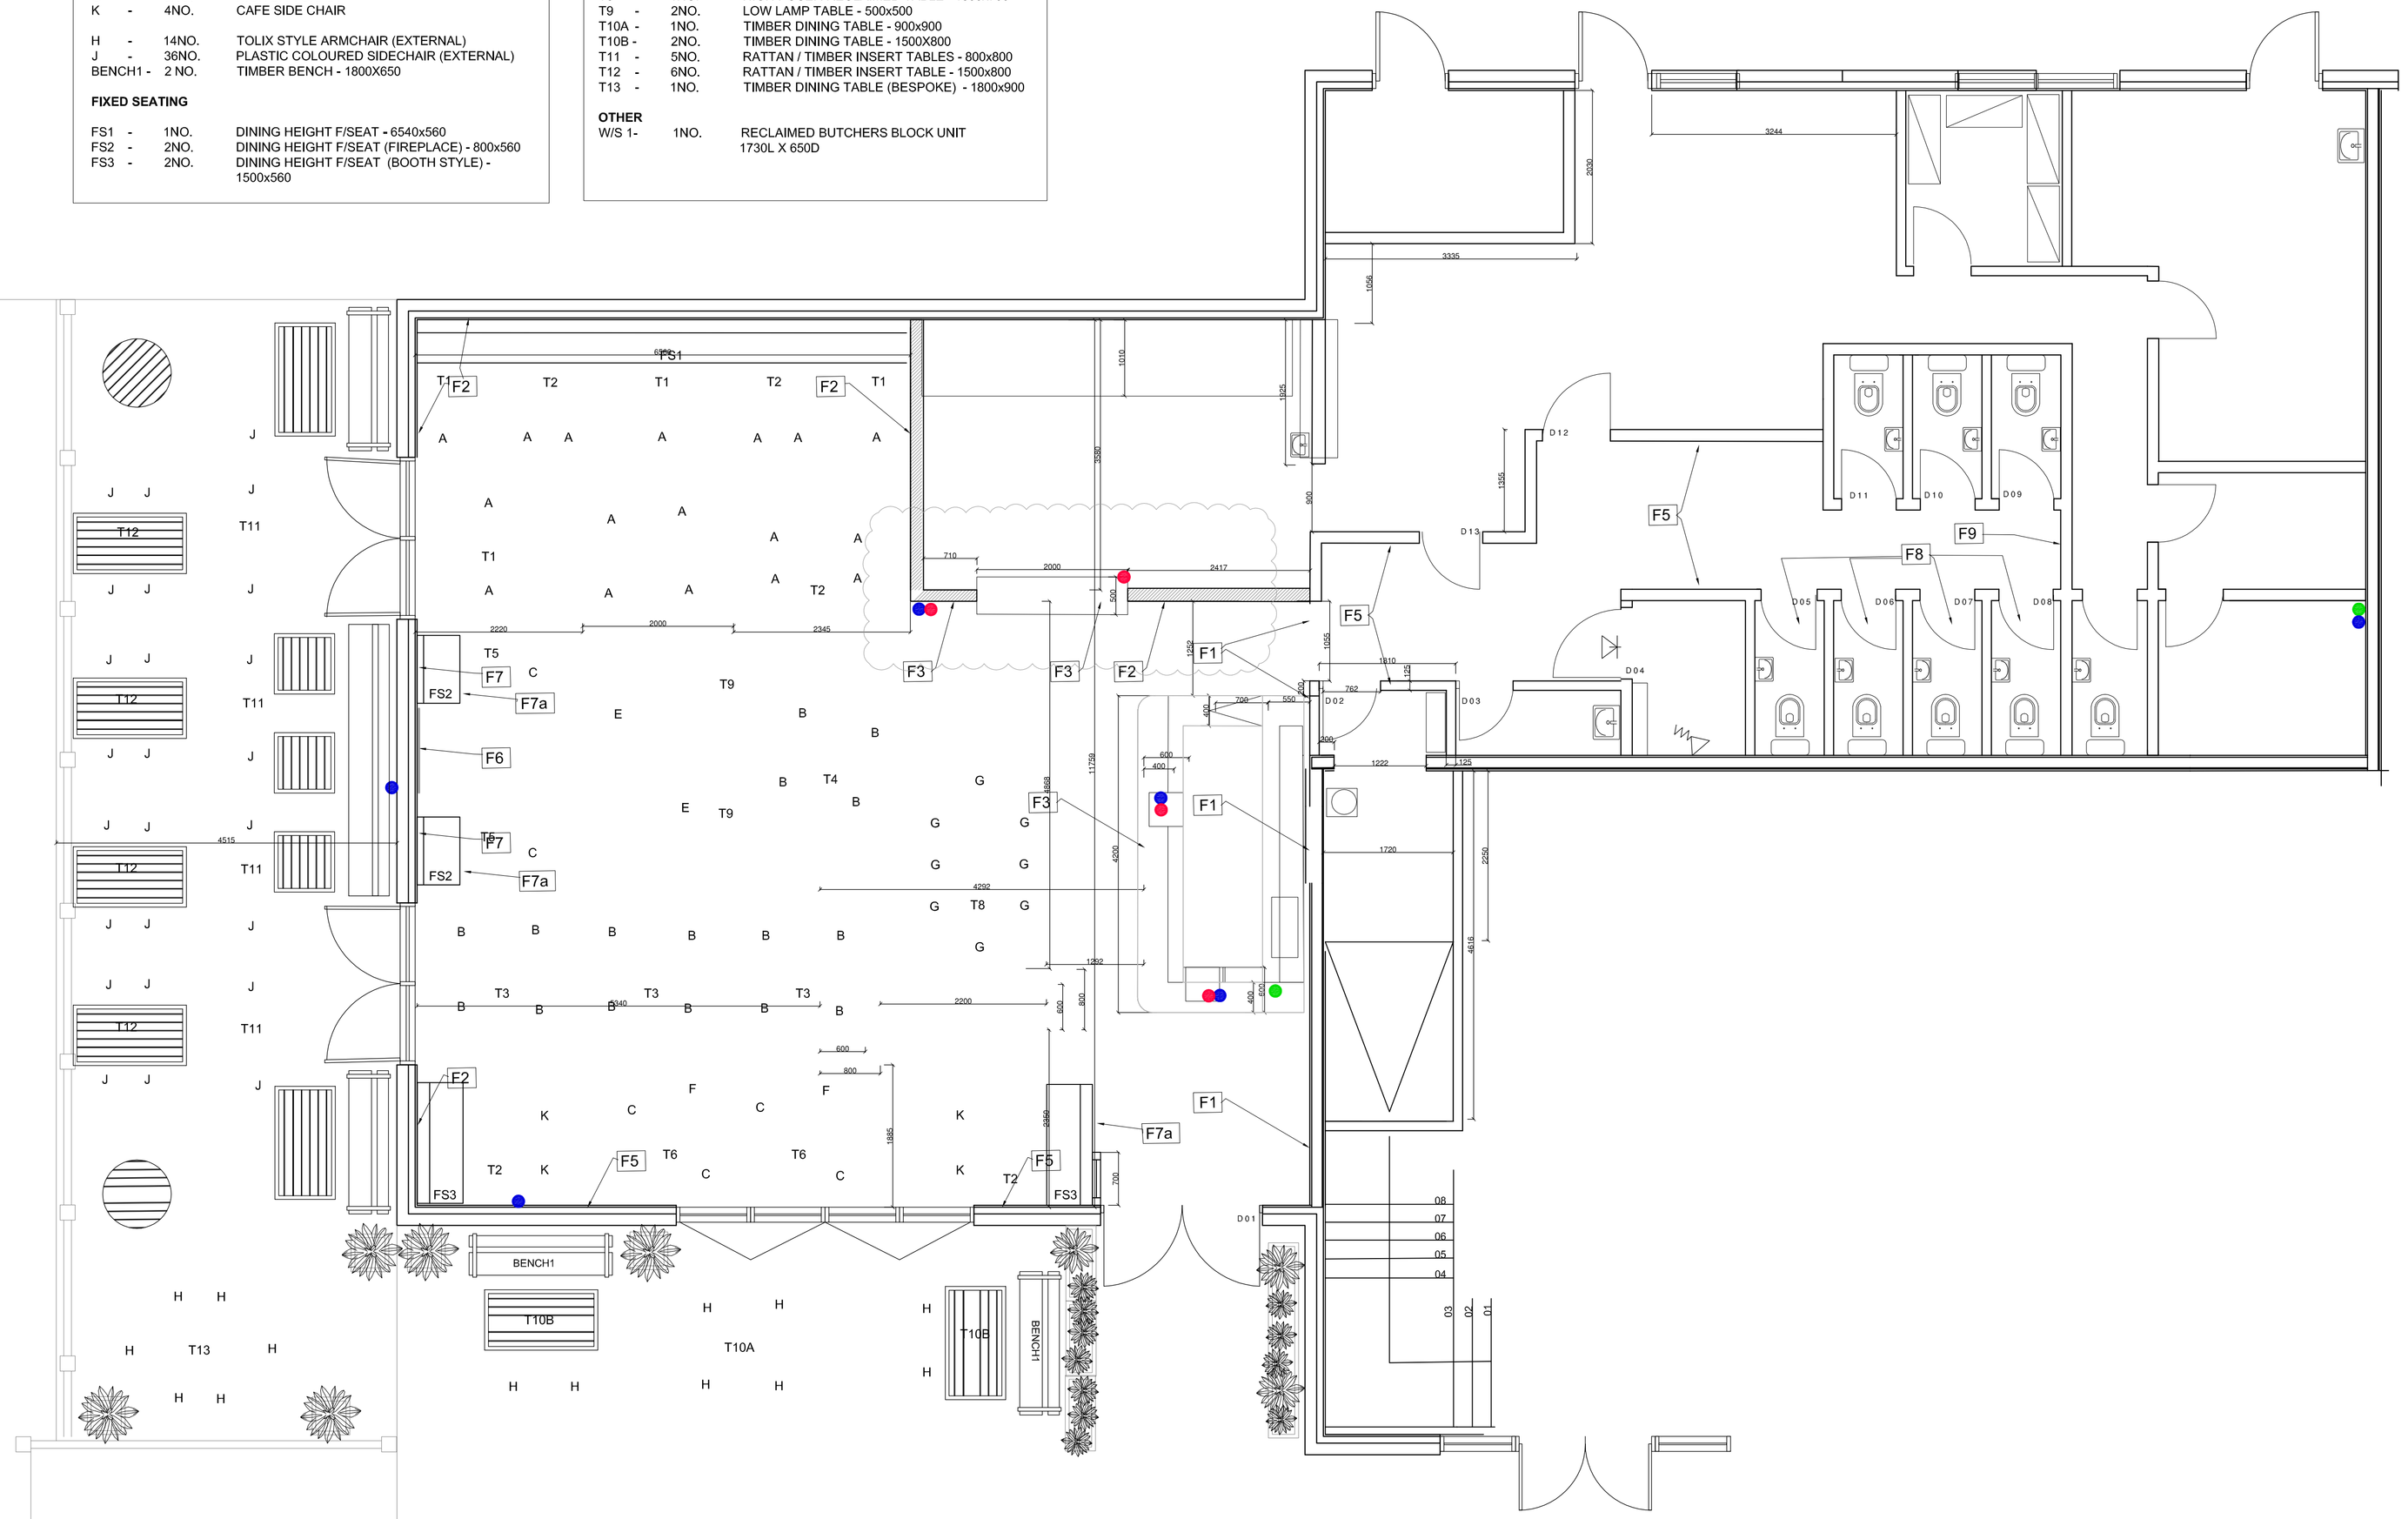

Copyright of this drawing is owned by Focus Design Ltd -
Do not reproduce, distribute without written consent.

All dimensions to be checked on site and any discrepancies notified prior to commencement of work.

FOCUS DESIGN Ltd
The Old Pumping Station, Main Road, Littleton, Winchester, Hampshire, SO22 6PR.
01962 850000

Origin: ☐ CAD ☐ IMAGE ☐ SURVEY

Status: ☐ For Information ☐ For Tender ☐ For Construction ☐ As Built Drawing

DATES	REV	COMMENTS
06.08.13	D	AMENDS TO KITCHEN PASS OPENING
19.07.13	C	SITE REVIEW AMENDS
21.05.13	B	AMENDS TO BOH LAYOUT
07.05.13	A	RELOCATE WASH UP & ADJUST BAR

FOCUS DESIGN

CLIENT
PREMIER MARINAS

PROJECT
CHICHESTER MARINA
BIRDHAM
WEST SUSSEX
PO20 7EJ

DRAWING TITLE
IDEAL COLLECTION PROPOSED SETTING OUT PLAN

SCALE : 1:50 @ A1

DATE : JAN '13

DRAWN BY : MH

SP39.13.102

D