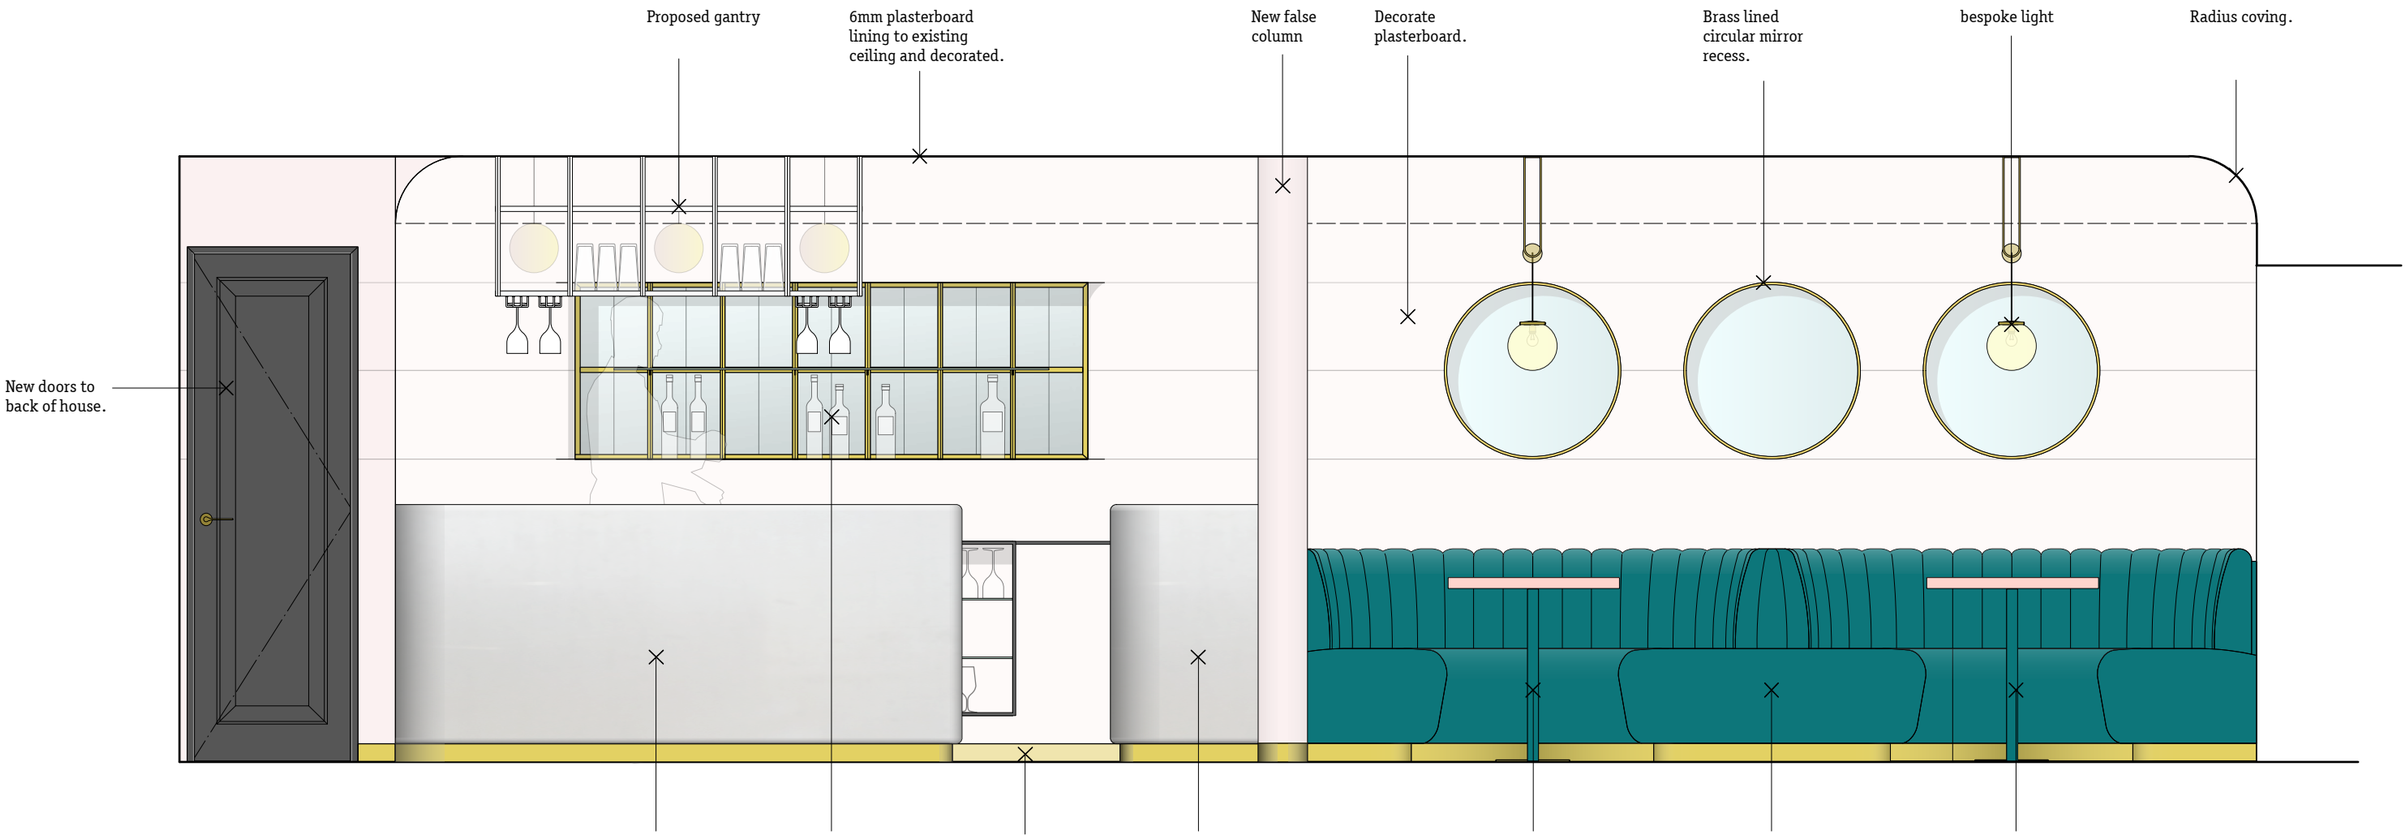

1 Proposed Elevation A
Scale: 1:25

Notes
-

Revision	Date	Description
-	-	-

Gundry & Ducker
Gundry & Ducker Architecture Ltd
3 Garrick Street
London WC2E 9BF
t +44(0)203 417 4895
info@gundryducker.com

Do not scale. All dimensions to be confirmed on site.
Information contained in this drawing is the sole copyright of the designer and is not to be reproduced without permission.

Project	NAC Basement		
Drawing title	Proposed Elevations		
Scale	1:25 @ A3	Drwg. No.	Rev
Date	September 2017	**327_GR_01**	/
Status	As Built		