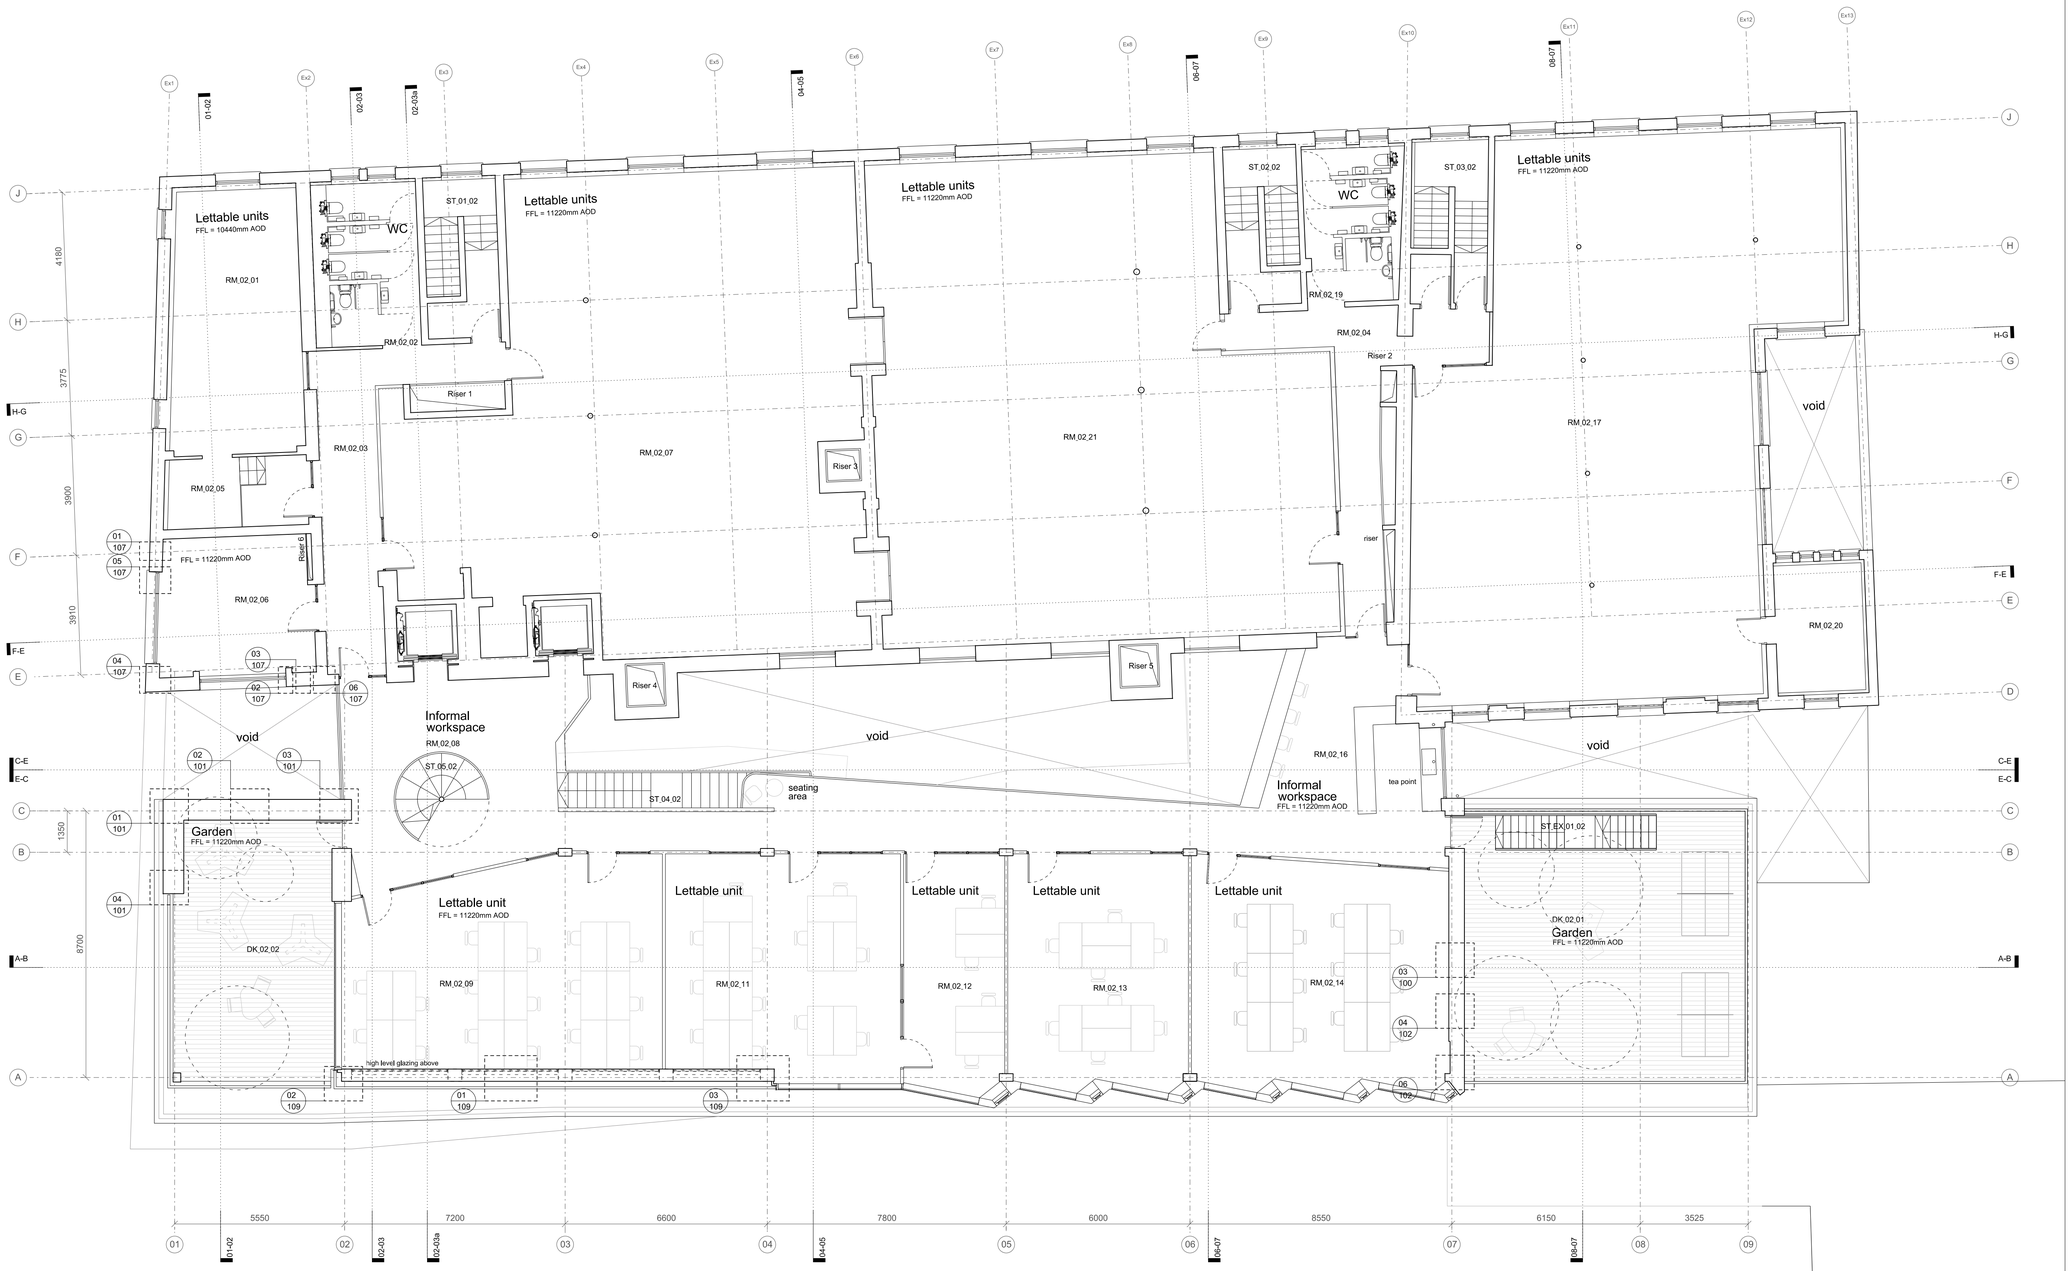

01_ Second Floor Plan

00 01 05 10m

Rev	Notes	Date
J	AS BUILT	10/08/2014
I	Partition removed and door + screen added	18/07/2014
H	Opening rellocated, Tea point wall angle amended, Lift and link bridge location amended, Partition moved to 01	21/02/2014
G	Riser removed, Existing steps retained, Partition removed, Door location amended, Existing structure retained, Existing door location retained	20/09/2013
F	CONSTRUCTION ISSUE	06/08/2013
E	Changes from Tender set bubblled inc: Atrium Glass Roof altered to accommodate atrium change Staircase amended Internal glazed partition replaced with stud wall Stud wall and door added to NE corner	30/04/2013
D	Internal glazed partitions reduced	08/04/2013
C	Staircase amended, Atrium size altered, Room notation	18/02/2013
B	Minor plan amendments	17/12/2012
A	Plan amendments	29/11/2012

Do not scale from this drawing, Check all dimensions on site

Site/Location plan:

Graphic Scale:

Project:

Social Justice Centre
17-19 Oval Way
Lambeth
SE11 5RH

Title:

Second Floor Plan

00:/ Architecture 00 Ltd.
The Hub, 1st floor NZH T: +44 (0)207 739 2230
80 Haymarket
London SW1Y 4TE
www.architecture00.net E: info@architecture00.net

AS BUILT

Scale: 1:100 @ A1 (1:200 @ A3)	Drawn: LP	Issued: LP	Date: 24/10/12

Project No: 0144 Drawing No: 0144 (L)013 Revision: J