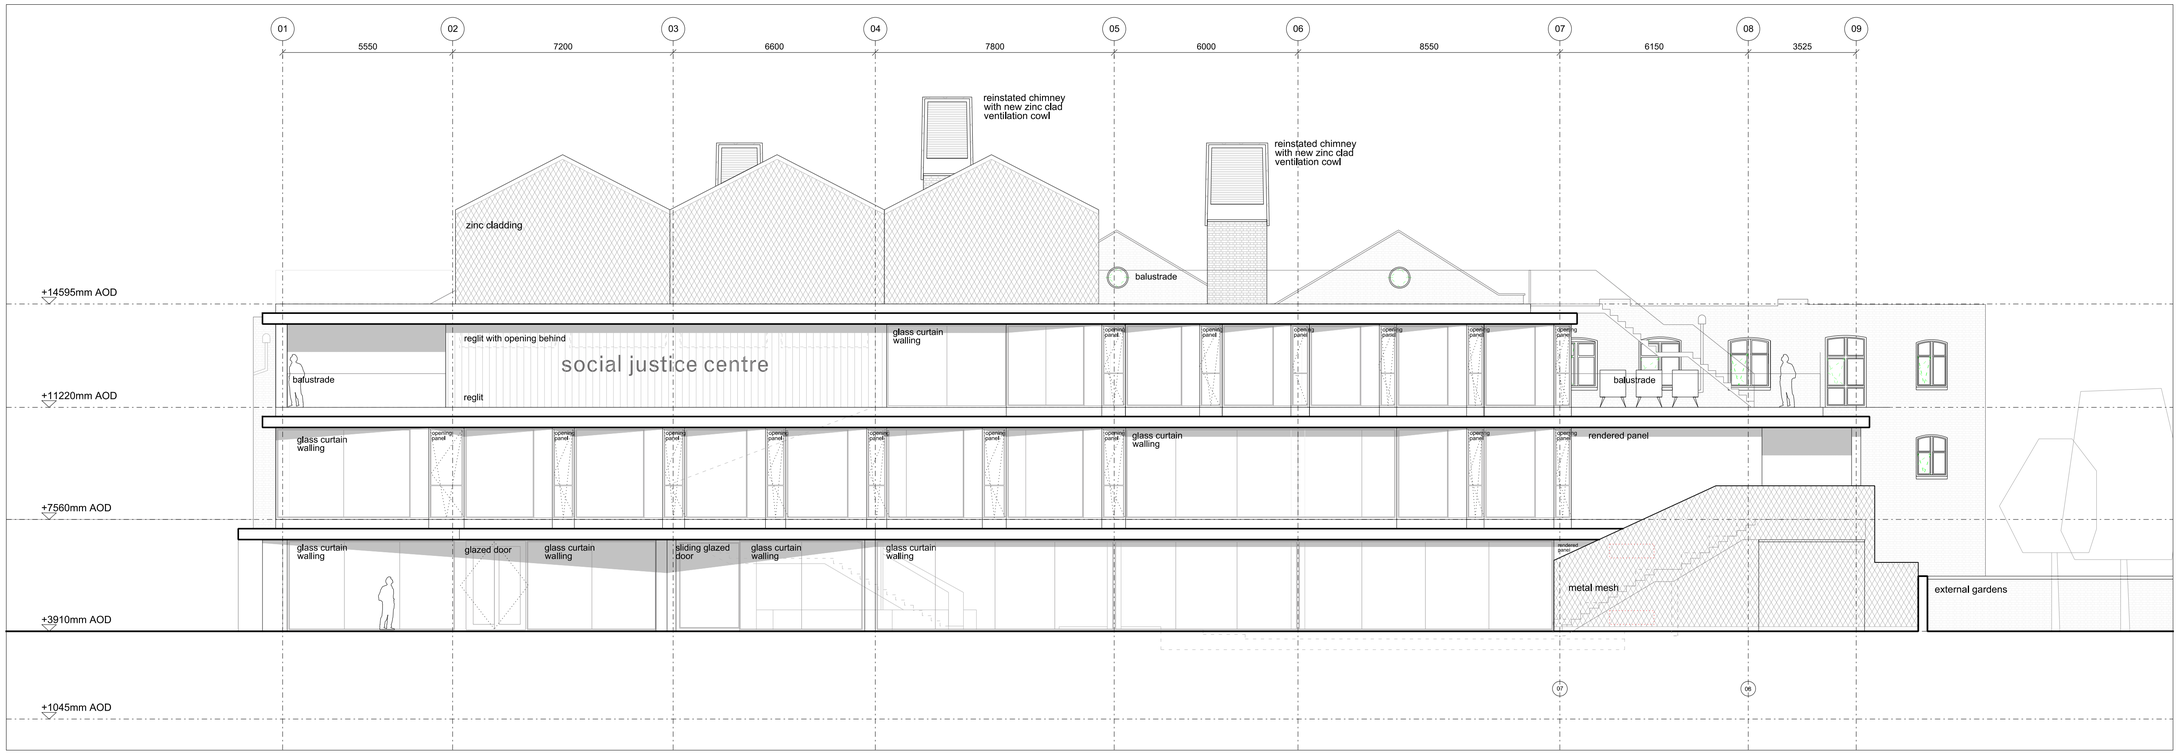

01_ West Elevation

02_ East Elevation

00 01 05 10m

Rev	Notes	Date
F	AS BUILT	10/08/2014
E	extract grills added	20/09/2013
D	CONSTRUCTION ISSUE	06/08/2013
C	Changes from Tender set bubbled inc: Pavilion and External stair cladding changed from timber Pavilion roof changed to reflect structural components drawing Ground floor folding door are reduced Existing building opening lights reduced	30/04/2013
B	Annotation amended	18/02/2013
A	Minor amendments	29/11/2012

Do not scale from this drawing. Check all dimensions on site

Site/Location plan:

Graphic Scale:

Project:

Social Justice Centre
17-19 Oval Way
London
SE11 5RH

Title:

Proposed Elevations
West and East

00:/ Architecture 00 Ltd.
The Hub, 1st floor NDH T: +44 (0)207 739 2230
80 Haymarket
London SW1Y 4TE
www.architecture00.net E: info@architecture00.net

AS BUILT

Scale: 1:100 @ A1 1:50 @ A1	Drawn: LP	Issued: LP	Date: 27/07/12

Project No: D144 Drawing No: D144 (L)030 Revision: F